2175 N Wenatchee AVE

My office

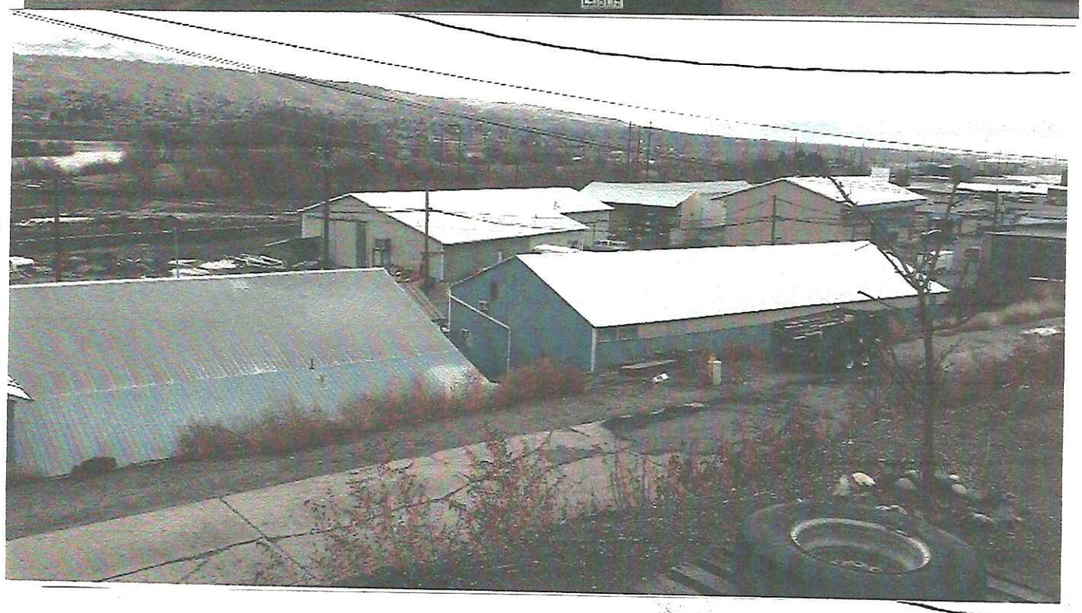

Buildings Behind my office

Building South of my office

Looking Back South of office

CITY OF WENATCHEE

JAN 29 2016

NORTH SIDE

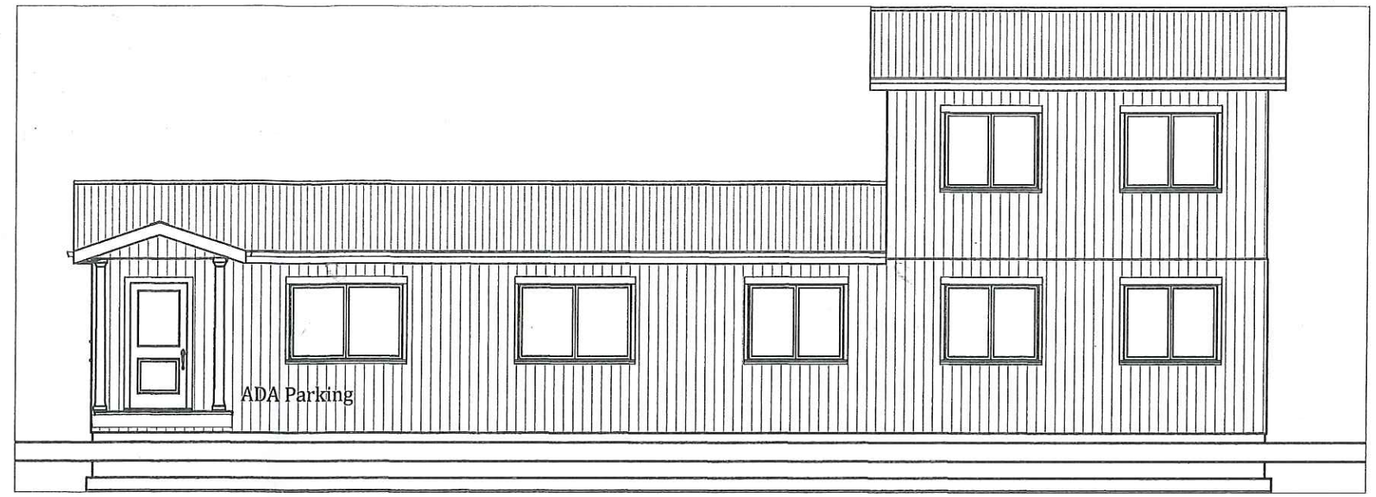

WEST SIDE

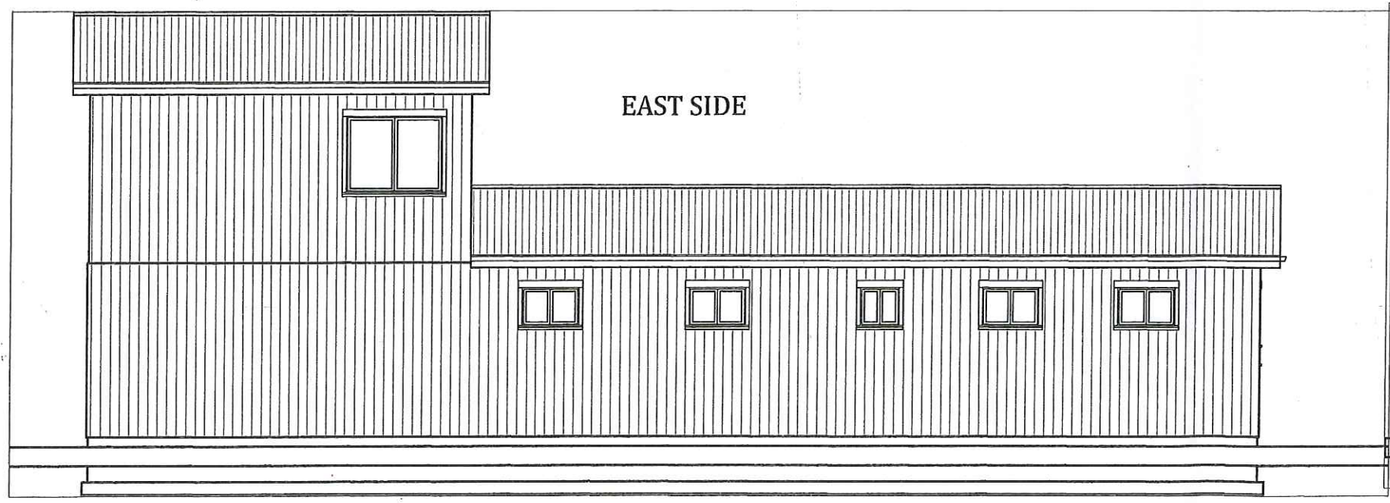

EAST SIDE

SOUTH SIDE

CITY OF WENATCHEE
JAN 29 2016

BOLYARD CNSTRUCTION
Gordon W Bolyard
Wenatchee, WA. 98801

DESIGNED FOR
MIKE WOOD AUTO
Ph: 509 663-4777

BY Gordon W Bolyard

Customer Address
2175 North Wenatchee, Ave.
Wenatchee, WA. 98801

Presentation View
ELEV VIEWS

	DATE	BY
DWN	11/11/15	GWBolyard
REV		

SCALE SEE VIEW
Applicable on Arch B Paper
1/8" = 1'-0"
DATE

SHEET #
1

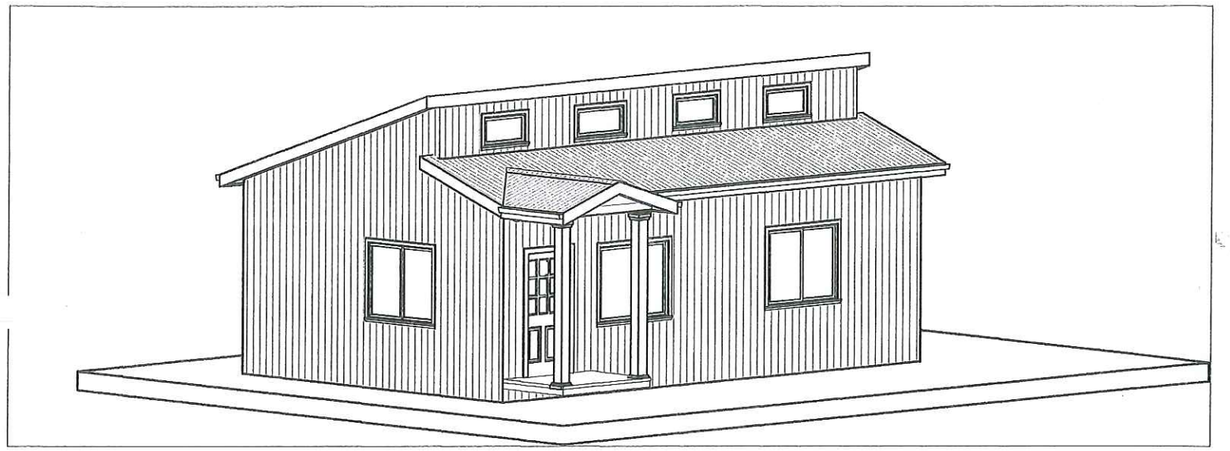

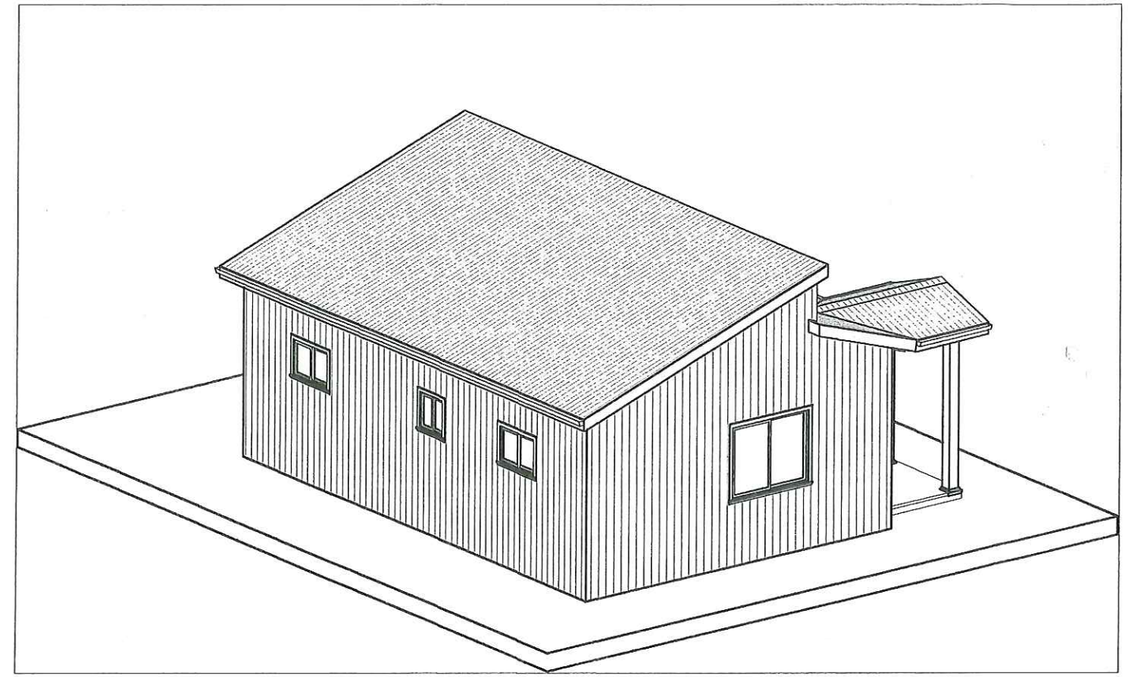

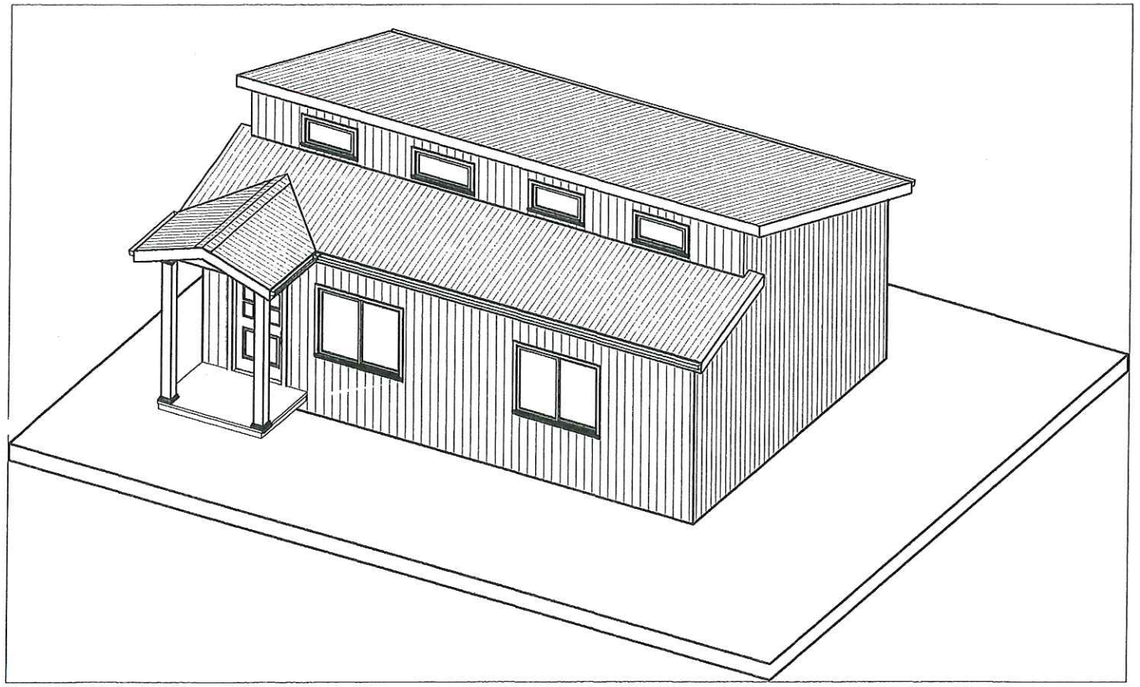

CITY OF WENATCHEE

JAN 29 2016

BOLYARD CNSTRUCTION *Gordon W Bolyard* Wenatchee, WA. 98801	DESIGNED FOR MIKE WOOD AUTO Ph: 509 663-4777 BY Gordon W Bolyard	Customer Address 2175 North Wenatchee, Ave. Wenatchee, WA. 98801	Presentation View AS BUILT 1984		DATE	BY
				DWN	11/11/15	GWBolyard
				REV	12/22/2015	

SCALE SEE VIEW Applicable on Arch B Paper	SHEET #
1/8" = 1'-0"	11
DATE	